

SEVEN SAINT PAUL STREET
BALTIMORE, MARYLAND 21202-1626
TELEPHONE 410 547-8700
FAX 410 752-7092

301 COLUMBIA CORPORATE CENTER
10440 LITTLE PATUXENT PARKWAY
COLUMBIA, MARYLAND 21044
TELEPHONE 410 884-0700
FAX 410 884-0719

JOSEPH D. DOUGLASS
DIRECT NUMBER
202 659-6779
jdouglass@wtplaw.com

WHITEFORD, TAYLOR & PRESTON
L.L.P.

1025 CONNECTICUT AVENUE, NW
WASHINGTON, D.C. 20036-5405

202 659-6800
FAX 202 331-0573
www.wtplaw.com

210 WEST PENNSYLVANIA AVENUE
TOWSON, MARYLAND 21204-4515
TELEPHONE 410 832-2000
FAX 410 832-2015

1317 KING STREET
ALEXANDRIA, VIRGINIA 22314-2928
TELEPHONE 703 836-5742
FAX 703 836-0265

March 28, 2001

RECEIVED MAR 30 2001


Ms. Ruchita Patel
The Management Group Associates, Inc.
One Bank Street, Suite 301
Gaithersburg, Maryland 20878-1504

Re: **Decoverly IV - Key West Condominium**
File #00006

Dear Ruchita:

Enclosed, as you requested, is a copy of the Addendum to Mutual Ingress, Egress, Maintenance and Parking Easement Agreement, as recorded in the Montgomery County land records on October 12, 2000. Please let me know if you have any questions.

Sincerely,

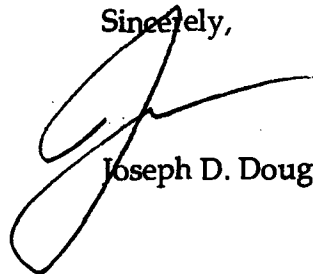

Joseph D. Douglass

Enclosure

ADDENDUM TO MUTUAL INGRESS, EGRESS, MAINTENANCE AND PARKING EASEMENT AGREEMENT

THIS ADDENDUM TO MUTUAL INGRESS, EGRESS, MAINTENANCE AND PARKING EASEMENT AGREEMENT (the "Addendum"), is made this 10th day of October, 2000, by and between Key West Condominium, Inc., ("Key West") and Decoverly IV Condominium, Inc.

NOV 12 10:48:5
FILED
MONTGOMERY COUNTY
RECORDS & CLERK

WITNESSETH:

WHEREAS, on August 19, 1992, a Mutual Ingress, Egress, Maintenance and Parking Easement Agreement (hereinafter referred to as "Agreement") was entered into by and between Key West Limited Partnership (the developer of the Key West Condominium) and Pulte Home Corporation (the developer of Decoverly IV Condominium) and such Agreement was recorded among the Land Records for Montgomery County, Maryland in Liber 10540 at Folio 425; and

WHEREAS, the Agreement is incorporated herein by reference to the extent not modified by this Addendum; and

RECORDING FEE 75.00
IMP TO SURE F 5.00
TOTAL 80.00
Book 10000 Page 1319
MAY KSI 91x 1 2319
Oct 12, 2000 10:47 am

WHEREAS, Exhibit A to the Agreement identifies the property which encompasses the Key West Condominium and Exhibit B to the Agreement identifies the property which encompasses the part of the Decoverly IV Condominium which is affected by the Agreement, and Exhibits A and B to the Agreement together encompass

SK

the property governed by the Agreement (hereinafter referred to as the "Property"); and

WHEREAS, the purpose of the Agreement was to provide mutual and reciprocal easements over and to the general common elements of Key West Condominium and the general common elements of Decoverly IV Condominium located within the Property, to each Condominium and the individual owners and residents of units within the Property for ingress, egress, maintenance and parking as the Condominiums were to be developed in close proximity requiring the need for access to and through each Condominium's common elements; and

WHEREAS, in addition to providing reciprocal easements, another purpose of the Agreement was to provide for the sharing of costs of maintenance and other services related to the Property between Key West Condominium and Decoverly IV Condominium; and

WHEREAS, while the Agreement identifies in detail the property encompassing Key West Condominium and the affected part of Decoverly IV Condominium, the general common elements of the Condominiums over which the easements are created are not specifically delineated in the Agreement; and

WHEREAS, since the completion of the development and construction of the Condominiums and the implementation of the Agreement, several issues have arisen

between Key West Condominium and Decoverly IV Condominium regarding the interpretation and operation of the Agreement; and

WHEREAS, Key West Condominium and Decoverly IV Condominium have resolved all issues regarding the interpretation and operation of the Agreement and have determined that this Addendum is necessary to clarify the agreements and obligations of the parties relative to the easements and maintenance requirements; and

WHEREAS, pursuant to Article V, Section 2 (i) and (l) of the Bylaws of Key West Condominium, Inc., Key West Condominium Board of Directors is given the authority to grant easements and other rights of use in all or any part of the common elements and to perform such other duties as may be necessary or advisable for the operation of the Condominium and as may be consistent with the Declaration, the Bylaws and applicable law and is further authorized to grant easements as may be considered necessary and appropriate by the Board of Directors for the orderly maintenance, preservation of the health, safety, convenience and/or welfare of the owners of the condominium units; and

WHEREAS, pursuant to Article V, Section 2 (i) of the Bylaws of Decoverly IV Condominium, Inc., Decoverly IV Condominium Board of Directors is given the authority to provide for the care, upkeep and surveillance of the common elements of the condominium and pursuant to Article V, Section 2 (i) of the Bylaws is given the

authority to grant easements in all or part of the common elements of the condominium;
and

NOW THEREFORE, in consideration of the above premises and for other good and valuable consideration, the receipt and sufficiency of which is hereby acknowledged, Key West Condominium and Decoverly IV Condominium hereby covenant and agree as follows:

1. The August 19, 1992 Mutual Ingress, Egress, Maintenance and Parking Easement Agreement made by and between Key West Limited Partnership and Pulte Home Corporation is specifically incorporated by reference and adopted into this Addendum, except to the extent that it is modified herein.
2. The mutual and reciprocal easements created by the Agreement encompass all of the general common elements of Key West Condominium and Decoverly IV Condominium located within the Property, with the exception of the building structures and foundations, the components of the electrical power, water, telephone, gas and sewer systems serving the buildings and the limited common elements. Such Easement Area is referred to in the Agreement as "Open Space" and is hereafter referred to as "Open Space Easement Area." Such Open Space Easement Area governed by the Agreement and this Addendum is depicted in Exhibit A hereto (composed of ten (10) pages) which Exhibit is specifically incorporated herein.

3. Paragraph 3 of the Agreement provides that Key West Condominium and Decoverly IV Condominium shall share, in accordance with the pro-ration established in Paragraph 4 of the Agreement, in the following costs associated with the Open Space Easement Area (Exhibit A hereto), which costs may be referred to as "Shared Maintenance Expenses":

- a. Reasonable costs and expenses for maintenance, repair and capital improvements of the Open Space Easement Area;
- b. Public liability insurance premiums covering the Open Space Easement Area;
- c. Electricity;
- d. Water;
- e. Cleaning;
- f. Snow removal;
- g. Lawn and tree maintenance;
- h. Repairs and maintenance to parking and driving areas;
- i. Resurfacing and restriping parking and driving areas;
- j. Maintenance and operation of lights and light standards;
- k. Landscaping, including annual plantings;
- l. Directional signs;
- m. Maintenance of storm drain facilities;
- n. Reasonable management fees regarding operation and management of Open Space Easement Area;
- o. Reasonable accounting fees regarding operation and management of Open

Space Easement Area;

- p. Reasonable attorney's fees regarding operation and management of Open Space Easement Areas and administration and enforcement of provisions of the Agreement and this Addendum.

4. The parties hereto agree that the above-described enumeration of costs and expenses to be shared by Key West Condominium and Decoverly IV Condominium creates several issues that require clarification. The following is intended to clarify any and all issues associated with the shared costs and expenses:

a. The following specific expenses will not be shared between Key West Condominium and Decoverly IV Condominium:

1) Public Liability Insurance Premiums. Despite the inclusion as a shared cost in the Agreement, each Condominium will maintain and pay premiums for its own public liability insurance covering all of its common elements, including those that are included in the Open Space Easement Area. Therefore, the shared maintenance budget required by the Agreement and this Addendum will not include costs for any public liability insurance premiums and each party will bear its own public liability insurance costs.

2) Foundation Plantings. All landscaping, including annual plantings, with the specific exception of any trees, that is located or to be located in the Open Space Easement Area between the sidewalk and the front of individual buildings of each condominium ("foundation plantings") shall be

performed at the expense of the Condominium within which the property is located, despite the fact that the areas in question are included in the Open Space Easement Area. Therefore, each party will make its own decision and bear the entire cost for its foundation plantings.

3) Cleaning. There are no cleaning expenses applicable to the Open Space Easement Area other than the regular maintenance issues contained in other categories.

b. The following specific expenses will be shared between Key West Condominium and Decoverly IV Condominium on the prorated basis provided in paragraph 4 of the Agreement:

1) With the exception of the foundation plantings described above in paragraph 4a.(2) and exterior lights not included in paragraphs 4b. (2) and (7) below, all costs and expenses for maintenance repairs and replacements, including capital improvements and reserves for the Open Space Easement Areas;

2) The electric costs for the exterior light posts (flood lights and one pole light located on the trash compactor island and three (3) street lights located on the island near building 15313). Such amount shall be calculated annually based upon the kilowatt per year ("KW/year") used at the current Pepco, or other applicable electric service provider, kilowatt per year ("KW/year") rate unless and until the electricity for such exterior light posts is

submetered;

3) The electric costs for the trash compactor. Such amount shall be calculated annually based upon the KW/year used by the trash compactor at the current Pepco or other applicable electric service provider KW/year rate. The KW/year shall be determined by multiplying the difference between the annual KW/year used of building 15306 and that used by building 15308 by the KW/year rate, unless and until the electricity for the trash compactor is submetered;

4) The installation costs of submetering for the car wash water spigot estimated to be \$575.00. After the spigot has been submetered, the parties will pay their prorated share of the water used.

5) Any maintenance, repair and replacement of the parking and driving areas, including resurfacing and restriping, and any reserves related thereto. It is agreed that all capital replacement expenses for the parking and driving areas will be paid first out of the reserves;

6) Snow removal, including all sidewalks within the Open Space Easement Areas up to the building entrance, which is defined as the doorway to the structure;

7) Any maintenance, repair and replacement of the exterior light posts (flood lights and one (1) pole light located on the trash compactor island and three (3) lights located on the island near Building 15313), and any reserves related thereto. It is agreed that all capital replacement expenses for such

exterior lighting will be paid first out of the reserves;

8) All landscaping of the Open Space Easement Areas, including annual plantings, shrubbery, mulching and any other landscaping services, with the specific exception of the maintenance of foundation plantings described above in paragraph 4a. (2);

9) Maintenance, repair and replacement of storm drain facilities, and any reserves related thereto. It is agreed that all capital replacement expenses for such storm drain facilities will be paid first out of the reserves;

10) Maintenance, repair and replacement of directional signs and any reserves related thereto. It is agreed that all capital replacement expenses for such signage will be paid first out of the reserves;

11) Thirty percent (30%) of the annual management fee for professional management services for Key West Condominium. For the 1999 budget year, the total management fee is \$13,077.00. The amount each year will be thirty percent (30%) of the total annual management fee for professional management services retained by Key West Condominium as such amount may be modified by market conditions. The total annual management fee referred shall be for the entire Key West Condominium including its obligations associated with the Open Space Easement Areas pursuant to the Agreement and this Addendum;

12) Key West Condominium shall retain a qualified accounting firm to perform an annual audit. Thirty-eight and one-half percent (38.5%) of the fee

for the annual audit will be charged as a shared maintenance expense to be paid by both Key West Condominium and Decoverly IV Condominium pursuant to the pro rata arrangement described above. For the 1999 budget year, the total cost of the annual audit is \$1,340.00. This amount may be modified from year to year by market conditions. The annual audit referred to herein shall be for Key West Condominium's entire finances, including its financial responsibilities associated with the Open Space Easement Areas pursuant to the Agreement and this Addendum;

13) Reasonable legal fees incurred regarding the operation and management of the Open Space Easement Areas and administration and enforcement of the Agreement and this Addendum.

5. The Open Space Easement Areas will be inspected quarterly for compliance with the Agreement and this Addendum. Such inspections will be performed by designated members of the Board of both Key West Condominium and Decoverly IV Condominium and/or the Condominium's management agents.

6. Paragraphs 5 and 6 of the Agreement address, to some extent, the budgeting, collection and accounting for the above-enumerated Shared Maintenance Expenses. The parties agree that the procedure outlined in the Agreement has limited detail and explanation and has created numerous issues between the parties. Therefore, Paragraphs 5 and 6 of the Agreement shall no longer be applicable and the procedures

relating to budgeting, collection and accounting for the above-enumerated Shared Maintenance Expenses shall be as outlined in this Addendum.

7. Key West Condominium shall be responsible for performing the maintenance, repair and replacement of the Open Space Easement Areas in accordance with the specific details outlined in the Agreement and this Addendum. Key West Condominium shall annually prepare a proposed annual budget, including reserve analysis and reserve budget, for the Shared Maintenance Expenses associated with the Open Space Easement Areas. The budget process shall be in accordance with the following procedure:

a. Key West Condominium shall submit such proposed budget, reserve analysis and reserve budget to Decoverly IV Condominium annually on or before September 1.

b. The Key West Condominium Board of Directors will discuss this proposed budget, reserve analysis and reserve budget at the September Board meeting of the Key West Condominium as its first agenda item, unless otherwise agreed by the parties. Any member of the Decoverly IV Condominium Board of Directors and/or a representative of the Board may attend the September Board meeting of the Key West Condominium and may participate in the discussion regarding the proposed Shared Maintenance Expense budget, reserve analysis and reserve budget. Key West will provide the date of its September Board meeting to the Decoverly IV Condominium not later than the June 1st prior to that meeting. In the event that the Key West Condominium Board meeting date, for its September meeting, conflicts with that of the

Decoverly IV Condominium Board, it is agreed between the parties that Decoverly IV Condominium will change its September Board meeting date. In the event of unforeseen circumstances, such as those which will affect Key West's ability to obtain a quorum at the meeting, or circumstances which are out of Key West's control, the September Board meeting will be rescheduled after consultation with the Decoverly IV Condominium and using the best efforts to accommodate the schedules of the Decoverly IV Board members.

c. Decoverly IV Condominium shall be given until October 1 to provide Key West Condominium with formal comment on the budget, reserve analysis and reserve budget, and any suggested modifications. Key West will consider the comments and revisions to the budget made by the Decoverly IV Board of Directors and, upon such consideration will, in its discretion, determine if modifications are warranted. Key West shall provide a revised draft budget, reserve analysis and reserve budget to Decoverly IV by October 15th.

d. The final adopted budget, reserve analysis and reserve budget will be issued by Key West Condominium by October 31 and submitted to Decoverly IV Condominium.

e. If there is a dispute between the parties regarding the budget, reserve analysis and/or reserve budget, the presidents (or other designated representatives) of the Board of Directors of each party shall meet to make a good faith attempt to resolve such dispute before taking any further action. The president or other designated Board representative shall have authority from his or her Board to resolve the dispute, if

possible. If after such meeting, the parties are unable to resolve the dispute, the dispute shall be resolved by arbitration in accordance with paragraph 9 of the Agreement.

8. Discoverly IV Condominium shall take into account its annual contribution toward the Shared Maintenance Expenses for the Open Space Easement Areas based upon the adopted annual budget and its pro ration, outlined in paragraph 4 of the Agreement, in preparing and adopting its annual budget. Discoverly IV Condominium shall be obligated to pay to Key West Condominium its annual contribution toward the Shared Maintenance Expenses for the Open Space Easement Areas in twelve (12) equal monthly installments. Such monthly installments shall be paid to Key West Condominium on or before the first day of each month. Such monthly installments shall be paid to Key West Condominium even if there is a pending dispute regarding the budget. If necessary and appropriate, an accounting shall be made at the resolution of such dispute.

9. If an extraordinary expense should arise regarding the Open Space Easement Areas, which was not included in the budget or in the reserve budget, that extraordinary expense may be assessed by Key West Condominium against both Key West Condominium and Discoverly IV Condominium in accordance with the applicable pro ration outlined in paragraph 4 of the Agreement so long as the following procedures are met:

a. Notice of the extraordinary expense~~s~~ is provided by Key West Condominium to Decoverly IV Condominium in writing or, in the event of an emergency, via telephone; and

b. The reason for the need for the extraordinary expense~~s~~ is provided by Key West Condominium to Decoverly IV Condominium in writing or, in the event of an emergency, via telephone; and

c. The parties agree to the extraordinary expense~~s~~ (such agreement shall be determined in accordance with each Condominium's Board of Directors' voting procedure).

d. If there is a dispute between the parties regarding the need for such extraordinary expense, the presidents (or other designated representatives) of the Board of Directors of each party shall meet to make a good faith attempt to resolve such dispute before taking any further action. The president or other designated Board representative shall have authority from his or her Board to resolve the dispute, if possible. If after such meeting, the parties are unable to resolve the dispute, the dispute shall be resolved by arbitration in accordance with paragraph 9 of the Agreement.

10. The annual shared maintenance budget shall not be increased from the prior year by more than ten percent (10%) without prior approval of both Condominium Associations obtained in accordance with each Condominium's board voting procedures. If there is a dispute between the parties regarding the need for an

increase of more than ten percent (10%) from the prior year's budget, the presidents (or other designated representatives) of the Board of Directors of each party shall meet to make a good faith attempt to resolve such dispute before taking any further action. The president or other designated Board representative shall have authority from his or her Board to resolve the dispute, if possible. If after such meeting, the parties are unable to resolve the dispute, the dispute shall be resolved by arbitration in accordance with paragraph 9 of the Agreement.

11. The following accounting procedure shall be used relative to the Shared Maintenance Expenses:

a. Key West Condominium shall provide an accounting of the previous year on a general line item basis on or before April 30th of the following year.

b. If there is a deficit from the previous year, Key West Condominium may specially assess against both Condominium Associations the additional amount necessary to cover such deficit in accordance with the special assessment procedure outlined in paragraph 9 of this Addendum, or may increase the current or next year's budgets subject to the cap limitations and procedure outlined in paragraph 10 of this Addendum, at Key West Condominium's option.

c. In the event of a surplus from the previous year, Key West Condominium may reimburse both Condominium Associations or may apply a credit to the current or next year's budget, at Key West Condominium's option. Key West shall apprise Decoverly IV of the option it chooses by April 30th, concurrently with its provision of an accounting

referred to in Paragraph 11a.


12. Key West Condominium, Inc. and Decoverly IV Condominium, Inc. hereby reserve the right to amend this Addendum by agreement in writing, executed in the same manner as this Addendum and recorded among the Land Records of Montgomery County, Maryland in the same manner as this Addendum.

13. The terms, covenants and conditions herein shall inure to the benefit of and shall be binding on the parties hereto and their respective successors and assigns.


14. Any provisions of the original Agreement not specifically amended or stricken by this Addendum shall remain in full force and effect as if wholly restated and incorporated herein.

IN WITNESS WHEREOF Key West Condominium, Inc. and Decoverly IV Condominium, Inc. have executed and acknowledged this Addendum to Mutual Ingress, Egress, Maintenance and Parking Easement Agreement on the day and year first written above.

ATTEST:

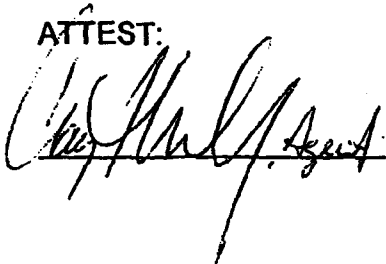

KEY WEST CONDOMINIUM, INC.

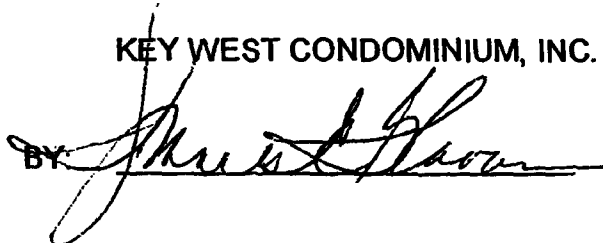BY 

ATTEST:

DECOVERLY IV CONDOMINIUM, INC.

Rion Wolpert

BY: Dennis E. Silverberg

EXHIBIT A
(10 pages)

OPEN SPACE EASEMENT AREAS
(represented by hatched areas of the following plats)

PLAN NO. 6301




W 33.500
N 89.200

PROPOSED PHASE 3

PARCEL 'B', BLOCK 4
DECOVERLY ADVENTURE
P.B. 155 P.NO. 17658

PROPOSED PHASE 4

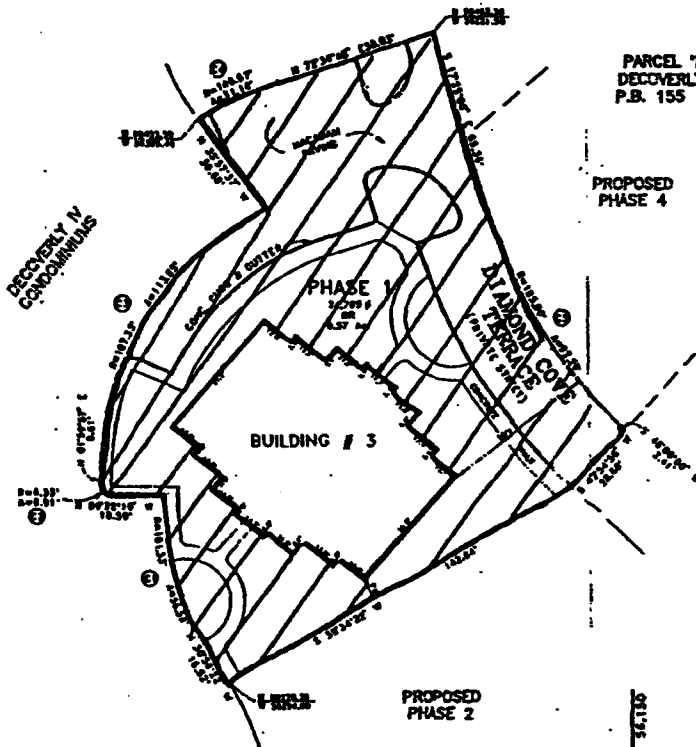

NOTES:

1. ".2" DENOTES A TOLERANCE OF PLUS OR MINUS 0.5 FEET.
2. ALL DIMENSIONS ARE EXTERIOR WALL MEASUREMENTS.
3. ALL PROPERTY OTHER THAN THE UNITS OR LIMITED COMMON ELEMENTS, APPROXIMATE TO 500 UNITS, AS SHOWN IN THE DECLARATION AND/OR SHOW PLAN IS GENERAL COMMON ELEMENT.
4. L.C.E. LIMITED COMMON ELEMENT
5. THE ENTIRE AREA SHOWN HEREON IS PART OF PARCEL 'B', BLOCK 4, DECOVERLY ADVENTURE, P.B. 155 P.No. 17658.

PROPOSED PHASE 5

W 33.500
N 89.200

PROPOSED PHASE 2

081°35' W
N 89.200

CONDOMINIUM PLAN
AS-BUILT PLAN
PHASE 1
KEY WEST
CONDOMINIUM, INC.
GAITHERSBURG (9th) DISTRICT
MONTGOMERY COUNTY, MARYLAND
SCALE: 1"=30' SEPTEMBER, 1992


CURVE DATA CHART							
STATION	CHORD BEARING	CHORD DISTANCE	CHORD BEARING	CHORD DISTANCE	CHORD BEARING	CHORD DISTANCE	CHORD BEARING
1	112°15'00"	100.00	112°15'00"	100.00	112°15'00"	100.00	112°15'00"
2	112°15'00"	100.00	112°15'00"	100.00	112°15'00"	100.00	112°15'00"
3	112°15'00"	100.00	112°15'00"	100.00	112°15'00"	100.00	112°15'00"
4	112°15'00"	100.00	112°15'00"	100.00	112°15'00"	100.00	112°15'00"
5	112°15'00"	100.00	112°15'00"	100.00	112°15'00"	100.00	112°15'00"
6	112°15'00"	100.00	112°15'00"	100.00	112°15'00"	100.00	112°15'00"
7	112°15'00"	100.00	112°15'00"	100.00	112°15'00"	100.00	112°15'00"
8	112°15'00"	100.00	112°15'00"	100.00	112°15'00"	100.00	112°15'00"
9	112°15'00"	100.00	112°15'00"	100.00	112°15'00"	100.00	112°15'00"
10	112°15'00"	100.00	112°15'00"	100.00	112°15'00"	100.00	112°15'00"

RECORDED: _____
 PLAN BOOK: _____
 PLAN NO.: _____

FILED
OCT 2 1992



Charles P. Johnson & Associates, Inc.
 PLANNING ENGINEERS LANDSCAPE ARCHITECTS SURVEYORS
 200 BOWEN ROAD SUITE 2000, GAITHERSBURG, MARYLAND 20878
 (301) 948-7100

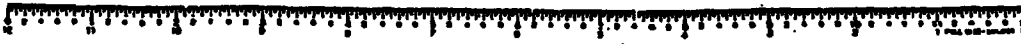

MARYLAND STATE ARCHIVES

PLAT NO. 6342

SURVEYOR'S CERTIFICATE



I HEREBY CERTIFY THAT THIS CONDOMINIUM PLAN, CONSISTING OF TWO (2) SHEETS IS EXACTLY THAT AS A CONDOMINIUM PLAN OF THE BUILDING AND IMPROVEMENTS LOCATED ON PARCELS B, BLOCK 2 AS SHOWN ON A PLAN OF SUBDIVISION ENTITLED "PARCELS 'U' AND 'V', BLOCK 'V', DISCOVERY ADVENTURE" AND RECORDED AMONG THE LAND RECORDS OF MONTGOMERY COUNTY, MARYLAND IN PLAN BOOK 129 AS PLAT NO. 17658. THIS IS IN ACCORDANCE WITH THE REQUIREMENTS OF TITLE 11 OF THE REAL PROPERTY ARTICLE, §§ 1-104 ET SEQ. OF THE ANNOTATED CODE OF MARYLAND, 1990 EDITION, AS AMENDED.

I FURTHER CERTIFY THAT THE LOCATION OF ALL EXISTING IMPROVEMENTS HAVE BEEN CAREFULLY ESTABLISHED BY ACCEPTED LAND SURVEYING PRACTICES AND THAT SAID EXISTING IMPROVEMENTS SHOWN THERE ARE NO VISIBLE ENCROACHMENTS.

I FURTHER CERTIFY THAT THE PLAN, VIEWED WITH THE APPLICABLE WORDING OF THE DECLARATION, IS A CORRECT REPRESENTATION OF THE CONDOMINIUM DESCRIBED AND THE CONVEYANCES AND LOCATION OF EACH UNIT AND THE COMMON ELEMENTS, AS CONSTRUCTED, CAN BE DETERMINED FROM THIS.

I FURTHER CERTIFY THAT THE AREA DESIGNATED HEREON AS PHASE 2 IS 36,100 SQUARE FEET OR 0.827 ACRES OF LAND.

Nov. 5, 1992

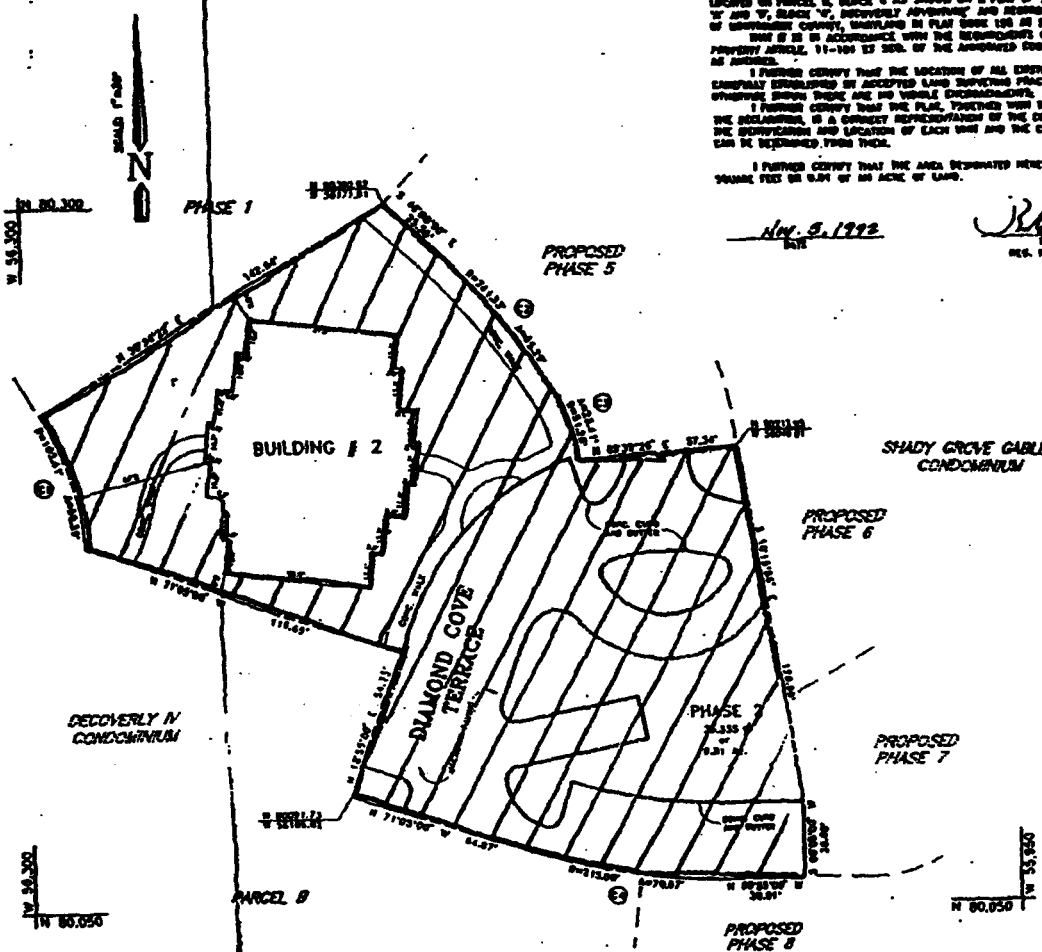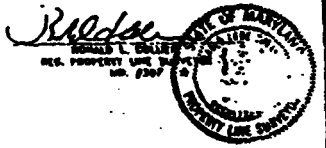

CONDOMINIUM PLAT
AS-BUILT PLAN
PHASE 2
KEY WEST
CONDOMINIUM, INC.
GANTHERSBURG (9TH) DISTRICT
MONTGOMERY COUNTY, MARYLAND
NOVEMBER, 1992 SCALE: 1"=30'

NO.	DATE	DESCRIPTION	BY	CHKD.	APP.

FILED
NOV 06 1992



Charles P. Johnson & Associates, Inc.
Professional Surveyors & Engineers
1000 WEST END ROAD SUITE 2000 WASHINGTON DC 20007
202-462-1000 FAX: 202-462-1001

N/F
R.O. CROWN, et al
L. 4227 F. 683

LAT NO. 6408

NOTES:

1. "±" DENOTES A TOLERANCE OF PLUS OR MINUS 0.5 FEET.
2. ALL DIMENSIONS ARE EXTERIOR WALL MEASUREMENTS.
3. ALL PROPERTY OTHER THAN THE UNITS OR LIMITED COMMON ELEMENTS, APPURTENANT TO SAID UNITS, AS DEFINED IN THE DECLARATION AND/OR SHOWA HEREIN IS GENERAL COMMON ELEMENT.
4. L.C.E. LIMITED COMMON ELEMENT
5. THE ENTIRE AREA SHOWN HEREON IS PART OF PARCEL B, BLOCK 4, RECOVERY ADVENTURE, P.B. 156 P.A.M. 17666.

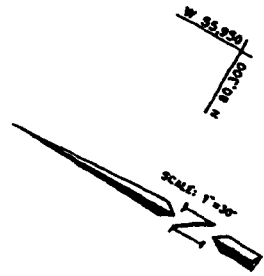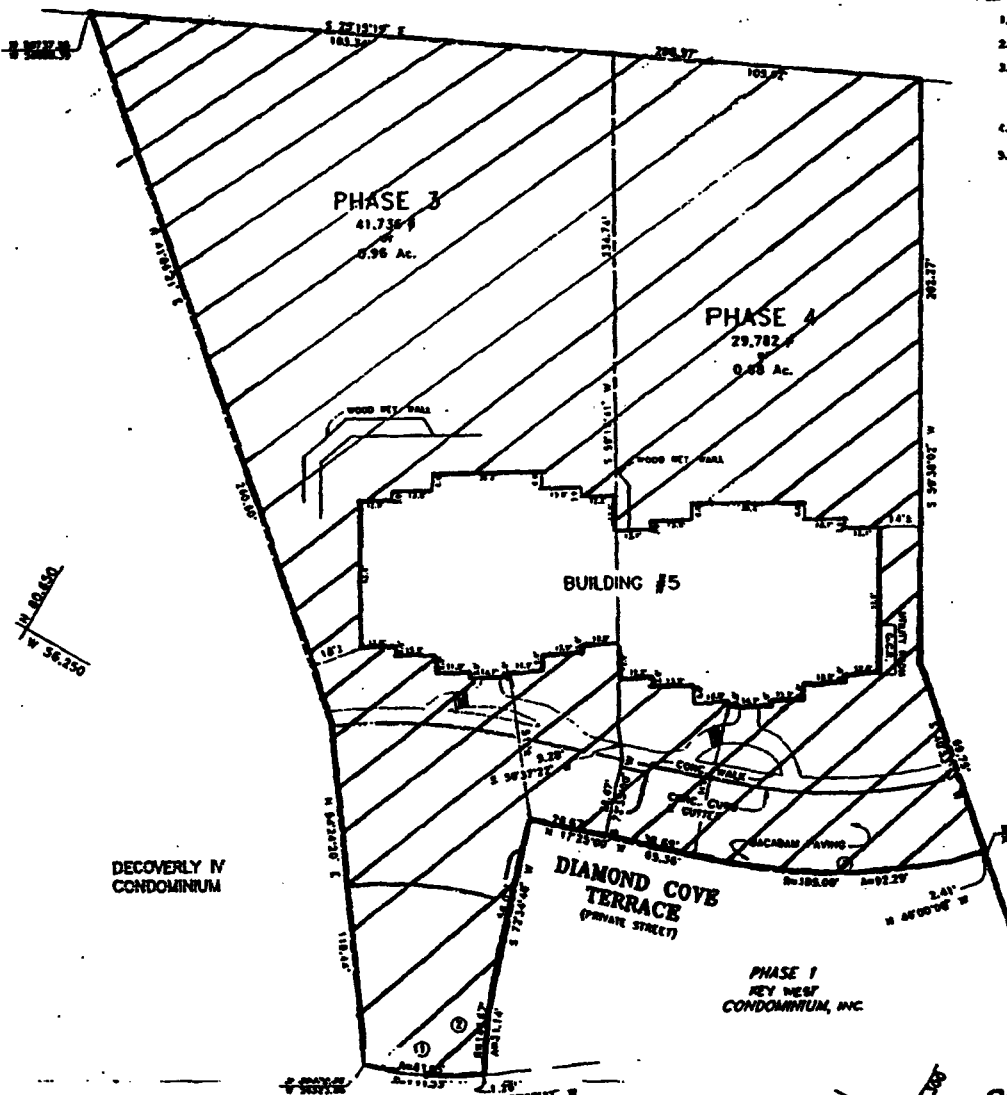

PROPOSED PHASE 5

KEY WEST CONDOMINIUM, INC.

JAN 19 1993

AS-BUILT PLAN
PHASES 3 & 4
KEY WEST
CONDOMINIUM, INC.
GATHERSBURG (9th) DISTRICT
MONTGOMERY COUNTY, MARYLAND
SCALE: 1"=30' JANUARY, 1993

CPA Charles P. Johnson & Associates, Inc.
PLANNING ENGINEER LICENSE NUMBER 0000000000
1000 EAST BROAD STREET, SUITE 200, ARLINGTON, VA 22202
(703) 531-1100


CURVE DATA CHART

Curve	Station	Chord	Angle	Radius	Chord	Angle	Radius
1	1+00.00	100.00	90.00	70.71	100.00	90.00	70.71
2	1+50.00	150.00	135.00	106.07	150.00	135.00	106.07
3	2+00.00	200.00	180.00	141.42	200.00	180.00	141.42
4	2+50.00	250.00	225.00	176.88	250.00	225.00	176.88
5	3+00.00	300.00	270.00	212.33	300.00	270.00	212.33
6	3+50.00	350.00	315.00	247.79	350.00	315.00	247.79
7	4+00.00	400.00	360.00	283.24	400.00	360.00	283.24




18469 113

PLAN NO. 6446

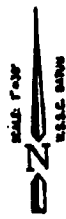

NOTES:

- 1. "±" DENOTES A TOLERANCE OF PLUS OR MINUS 0.5 FEET.
- 2. ALL DIMENSIONS ARE EXTERIOR WALL MEASUREMENTS.
- 3. ALL PROPERTY OTHER THAN THE UNITS OR LIMITED COMMON ELEMENTS APPURTENANT TO SAID UNITS, AS DEFINED IN THE DECLARATION AND/OR SHOWN HEREON IS GENERAL COMMON ELEMENT.
- 4. L.C.E. LIMITED COMMON ELEMENT
- 5. THE ENTIRE AREA SHOWN HEREON IS PART OF PARCEL 0, BLOCK 4, OCCOCHLY ADVENTURE, P.D. 130 P.M. 17000.

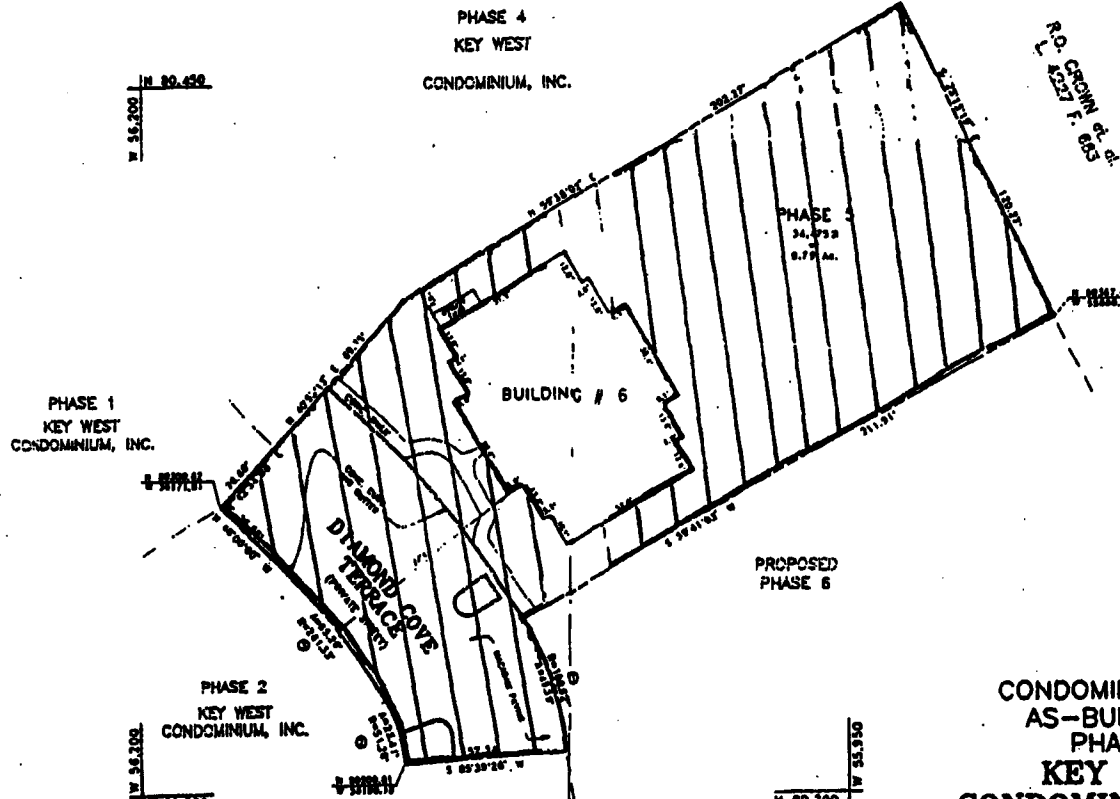


R.O. CROWN & SONS
14001 F. ST.

11 E-11
MAR 17 1993

CONDOMINIUM PLAT
AS-BUILT PLAN
PHASE 5
KEY WEST
CONDOMINIUM, INC.
GAITHERSBURG (91N) DISTRICT
MONTGOMERY COUNTY, MARYLAND
MARCH, 1993 SCALE: 1"=30'

RECORDED _____
PLAN BOOK _____
PLAN NO. _____

CURVE DATA	
1	10.00
2	10.00
3	10.00
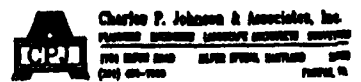


Sheet 2 of 1
11-11-93



PLAT NO. 648



- NOTES:
1. "±" SHOWS A TOLERANCE OF PLUS OR MINUS 0.5 FEET.
 2. ALL DIMENSIONS ARE EXTERIOR WALL MEASUREMENTS.
 3. ALL PROPERTY OTHER THAN THE UNITS OR LIMITED COMMON ELEMENTS, APPLICABLE TO THIS UNIT, AS SHOWN BY THE DECLARATION AND/OR SHOWS HEREON IS CLUSTERS COMMON ELEMENTS.
 4. L.C.E. UNITED COMMON ELEMENTS.
 5. THE ENTIRE AREA SHOWN HEREON IS PART OF PARCEL B, BLOCK 4, DECOVERLY ADVENTURE, P.B. 155 P.M. 17658.

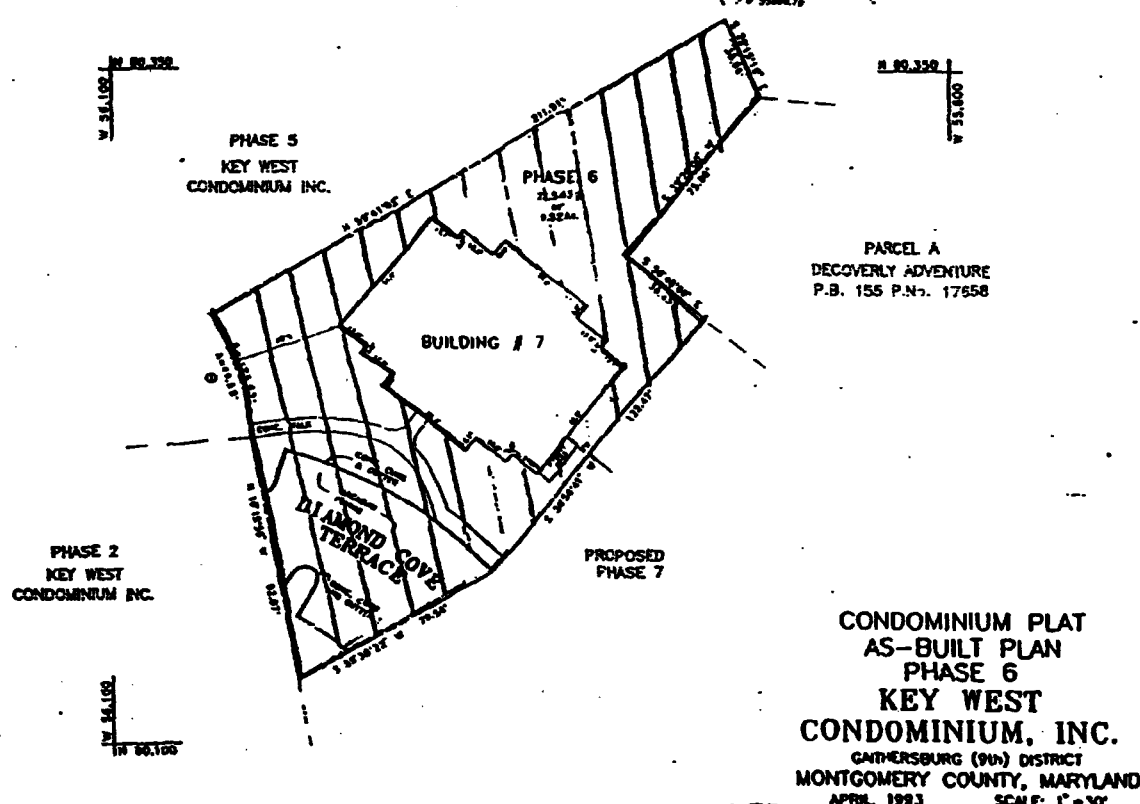

CONDOMINIUM PLAT
AS-BUILT PLAN
PHASE 6
KEY WEST
CONDOMINIUM, INC.
GATHERSBURG (9th) DISTRICT
MONTGOMERY COUNTY, MARYLAND
APRIL, 1993 SCALE: 1"=30'

FILED
APR 30 1993

Charles F. Johnson & Associates, Inc.
PLANNING ENGINEERING SURVEYING ARCHITECTURE
400 WEST BIRD ST. SUITE 200, GAITHERSBURG, MD 20878
PH 301-281-1100 FAX 301-281-1101

CURVE DATA			
STATION	CHORD BEARING	CHORD LENGTH	ARC LENGTH
1+00.00	S 89° 57' 00" W	100.00	100.00
1+10.00	S 89° 57' 00" W	100.00	100.00
1+20.00	S 89° 57' 00" W	100.00	100.00
1+30.00	S 89° 57' 00" W	100.00	100.00
1+40.00	S 89° 57' 00" W	100.00	100.00
1+50.00	S 89° 57' 00" W	100.00	100.00
1+60.00	S 89° 57' 00" W	100.00	100.00
1+70.00	S 89° 57' 00" W	100.00	100.00
1+80.00	S 89° 57' 00" W	100.00	100.00
1+90.00	S 89° 57' 00" W	100.00	100.00
2+00.00	S 89° 57' 00" W	100.00	100.00

RECORDED: _____
 PLAN BOOK: _____
 PLAN SHEET: _____


DATE: 4/30/93
 FILE: 18469-114



PLAT NO. : 6517

NOTES:

1. "2" INDICATES A TOLERANCE OF PLUS OR MINUS 0.5 FEET.
2. ALL DIMENSIONS ARE EXTERIOR WALL MEASUREMENTS.
3. ALL PROPERTY OTHER THAN THE UNITS OR LIMITED COMMON ELEMENTS, APPLICABLE TO THIS PLAN, IS DEFINED IN THE DECLARATION AND/OR SUPPLEMENTAL DECLARATION TO THE DECLARATION.
4. L.C.C. - LIMITED COMMON ELEMENT
5. THE OFFICE AREA SHOWN HEREON IS PART OF PARCEL B, BLOCK A, DISCOVERY ADVENTURE, P.B. 155 P.No. 17658.

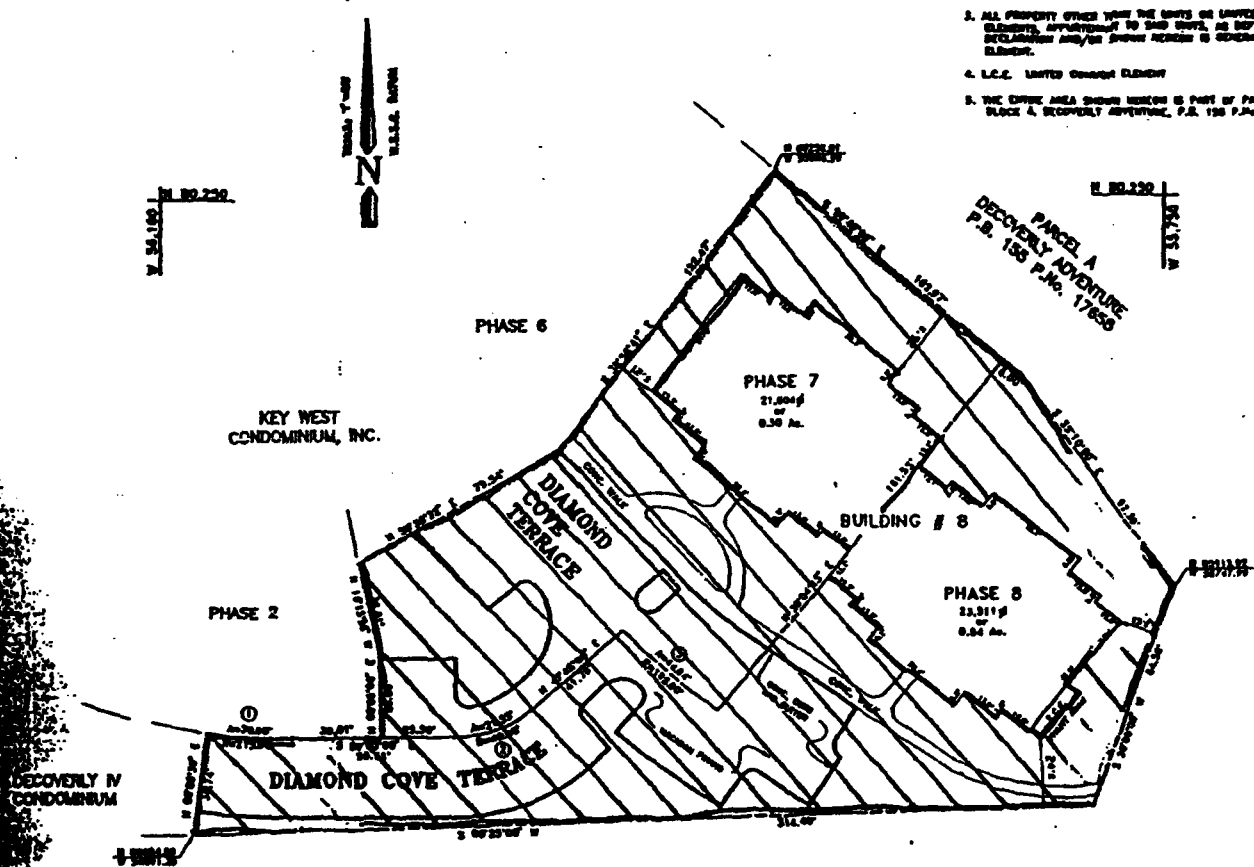

PARCEL A
DISCOVERY ADVENTURE
P.B. 155 P.No. 17658

CONDOMINIUM PLAT
AS-BUILT PLAN
PHASES 7 & 8
KEY WEST
CONDOMINIUM, INC.
GATHERSBURG (90) DISTRICT
MONTGOMERY COUNTY, MARYLAND
JUNE, 1993 SCALE: 1"=30'

CURVE TABLE									
CHORD BEING SUBTENDED	CHORD	ANGLE	ARC	ANGLE	CHORD	ANGLE	ARC	ANGLE	CHORD
100.00	100.00	90.00	157.08	90.00	100.00	90.00	157.08	90.00	100.00
150.00	150.00	135.00	235.62	135.00	150.00	135.00	235.62	135.00	150.00
200.00	200.00	180.00	314.16	180.00	200.00	180.00	314.16	180.00	200.00
250.00	250.00	225.00	392.70	225.00	250.00	225.00	392.70	225.00	250.00
300.00	300.00	270.00	471.24	270.00	300.00	270.00	471.24	270.00	300.00
350.00	350.00	315.00	549.78	315.00	350.00	315.00	549.78	315.00	350.00
400.00	400.00	360.00	628.32	360.00	400.00	360.00	628.32	360.00	400.00

FILED
JUN 21 1993




Charles P. Johnson & Associates, Inc.
PLANNING ENGINEERING ARCHITECTURE INTERIOR DESIGN
1001 20th St. Suite 2000, Rockville, MD 20850
301-984-7000 FAX: 301-984-7001

RECORDED _____
PLAT BOOK _____
PLAT NO. _____

MSA 33a1264-68-2

PLAT NO. 6857

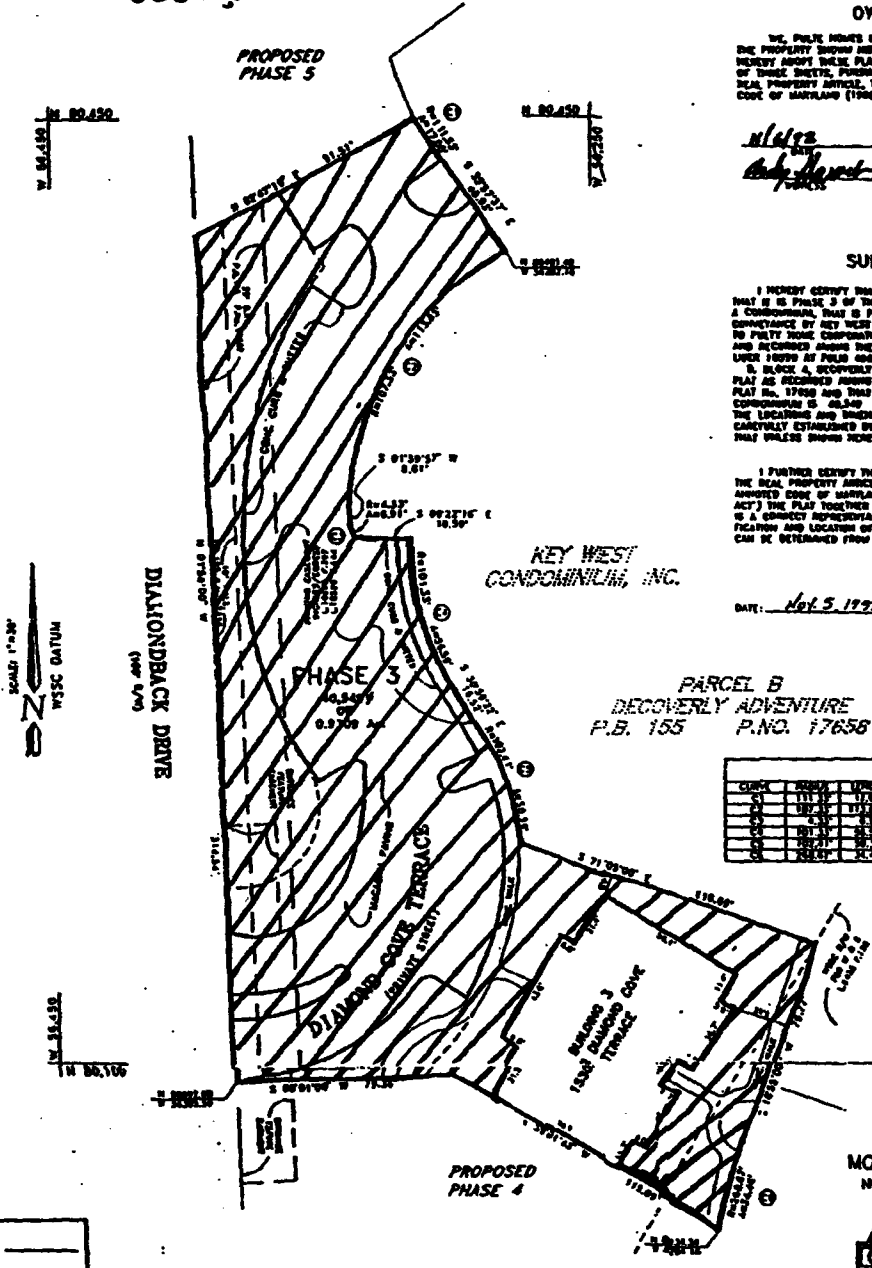

OWNER'S DEDICATION

WE, PULTE HOMES CORPORATION, A MICHIGAN CORPORATION, OWNERS OF THE PROPERTY SHOWN HEREIN AND DESCRIBED IN THE SURVEYOR'S CERTIFICATE, HEREBY ADOPT THESE PLANS AND PLANS OF CONDOMINIUM SUBDIVISION, CONSISTING OF THESE SHEETS, PURSUANT TO THE PROVISIONS AND REQUIREMENTS OF THE REAL PROPERTY ARTICLE, TITLE 21, SECTION 21-101, of the ANNOTATED CODE OF MARYLAND (1988 REPL. VOL.)

Handwritten signature
 PRESIDENT

Handwritten signature
 CHARLES L. JOHNSON
 PRESIDENT - PLYMOUTH OPERATING
 ATTORNEY IN FACT

SURVEYOR'S CERTIFICATE

I HEREBY CERTIFY THAT THE INFORMATION SHOWN HEREON IS CORRECT, THAT IT IS PHASE 3 OF THE PROPERTY SHOWN AS DISCOVERLY IV CONDOMINIUM, A CONDOMINIUM, THAT IS PART OF THE TRACT OF LAND DESCRIBED IN A CONVEYANCE BY KEY WEST LIMITED PARTNERSHIP, A MARYLAND LIMITED PARTNERSHIP TO PULTE HOMES CORPORATION, A MICHIGAN CORPORATION BY DEED DATED AUGUST 14, 1992, AND RECORDED AGAINST THE LAND RECORDS OF MONTGOMERY COUNTY, MARYLAND IN BOOK 10759 OF FOLIO 406, SAID PARCEL OF LAND ALSO BEING PART OF PARCEL B, BLOCK 4, DISCOVERLY ADVENTURE AS delineated on a subdivision second PLAT AS RECORDED AGAINST THE SPOTLAND LAND RECORDS IN PLAT BOOK 154 AS PLAT NO. 17658 AND THAT THE TOTAL AREA SHOWN ON PHASE 3 OF THIS CONVEYANCE IS 48.140 ACRES FEET OR 0.1300 OF AN ACRE OF LAND AND THAT THE LOCATIONS AND DIMENSIONS OF ALL EXISTING IMPROVEMENTS HAVE BEEN CAREFULLY ESTABLISHED BY A TRIMMED-LINE SURVEY (ON CONVEYANCE) AND THAT UNLESS SHOWN OTHERWISE THERE ARE NO WHOLE ENCROACHMENTS.

I FURTHER CERTIFY THAT IN ACCORDANCE WITH THE REQUIREMENTS OF THE REAL PROPERTY ARTICLE, TITLE 21, SECTION 21-102, of the ANNOTATED CODE OF MARYLAND (1988 REPL. VOL.) (THE MARYLAND CONDOMINIUM ACT) THE PLAN TOGETHER WITH THE APPLICABLE PORTIONS OF THE DECLARATION, IS A CORRECT REPRESENTATION OF THE CONDOMINIUM DESCRIBED AND THE IDENTIFICATION AND LOCATION OF EACH UNIT AND THE COMMON ELEMENTS, AS CONSTRUCTED, CAN BE DETERMINED FROM THEM.

DATE: Nov. 5, 1992

Handwritten signature
 RONALD L. COLLIER
 PROPERTY LINE SURVEYOR
 NO. 107

PARCEL B
 DISCOVERLY ADVENTURE
 P.B. 155 P.NO. 17658

CURVE DATA CHART


LINE	BEARING	LENGTH	CHORD BEARING	CHORD LENGTH	ARC LENGTH	ANGLE	AREA
1	S 89° 45' 00" W	11.31	S 89° 45' 00" W	11.31	11.31	0.00	0.00
2	S 89° 45' 00" W	11.31	S 89° 45' 00" W	11.31	11.31	0.00	0.00
3	S 89° 45' 00" W	11.31	S 89° 45' 00" W	11.31	11.31	0.00	0.00
4	S 89° 45' 00" W	11.31	S 89° 45' 00" W	11.31	11.31	0.00	0.00
5	S 89° 45' 00" W	11.31	S 89° 45' 00" W	11.31	11.31	0.00	0.00
6	S 89° 45' 00" W	11.31	S 89° 45' 00" W	11.31	11.31	0.00	0.00
7	S 89° 45' 00" W	11.31	S 89° 45' 00" W	11.31	11.31	0.00	0.00
8	S 89° 45' 00" W	11.31	S 89° 45' 00" W	11.31	11.31	0.00	0.00
9	S 89° 45' 00" W	11.31	S 89° 45' 00" W	11.31	11.31	0.00	0.00
10	S 89° 45' 00" W	11.31	S 89° 45' 00" W	11.31	11.31	0.00	0.00

FILED
 NOV 13 1992

SHEET 2 OF 3
 CONDOMINIUM PLAT
 PHASE THREE
 DISCOVERLY IV
 CONDOMINIUM
 GAITHERSBURG (91A) DISTRICT
 MONTGOMERY COUNTY, MARYLAND
 NOVEMBER, 1992 SCALE: 1" = 30'

CPJ Charles P. Johnson & Associates, Inc.
 PLANNED SURVEYING ENGINEERS ARCHITECTS
 200 BERRY ROAD GAITHERSBURG, MARYLAND 20878
 (301) 471-1100

RECORDED: _____
 PLAT BOOK: _____
 PLAT NO.: _____

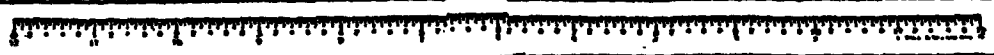

PLAT. No. 6970

PARCEL B
DISCOVERY ADVENTURE
P.B. 155 P.NO. 17658

OWNER'S DEDICATION

WE, PLATE HOME CORPORATION, A MICHIGAN CORPORATION, OWNERS OF THE PROPERTY SHOWN HEREON AND DESCRIBED IN THE SURVEYOR'S CERTIFICATE, HEREBY ADOPt THESE PLATS AND PLANS OF CONDOMINIUM DEVELOPMENT, CONSISTING OF THESE SHEETS, PURSUANT TO THE PROVISIONS AND REQUIREMENTS OF THE REAL PROPERTY ARTICLE, TITLE 11, SECTION 11-101, of the ANNOTATED CODE OF MARYLAND (1988 REPL. VOL.)

11/17/92
DATE
Charles K. McGovern
PRESIDENT

PLATE HOME CORPORATION
Charles K. McGovern
PRESIDENT - PERSONAL OPERATIONS
ATTORNEY IN FACT

SURVEYOR'S CERTIFICATE

I HEREBY CERTIFY THAT THE INFORMATION SHOWN HEREON IS CORRECT, THAT IT IS PHASE 4 OF THE PROPERTY SHOWN AS DISCOVERY IV CONDOMINIUM, A CONDOMINIUM, THAT IS PART OF THIS TRACT OF LAND DESCRIBED IN A CONVEYANCE BY KEY WEST LAYERS PARTNERSHIP, A MARYLAND LIMITED PARTNERSHIP TO PLATE HOME CORPORATION, A MICHIGAN CORPORATION BY DEED DATED AUGUST 14, 1991 AND RECORDED AMONG THE LAND RECORDS OF MONTGOMERY COUNTY, MARYLAND IN BOOK 16800 AT FOLIO 800, SAID PARCELS OF LAND ALSO BEING PART OF PARCEL B, BLOCK A, DISCOVERY ADVENTURE AS DESCRIBED ON A SURVEYOR'S RECORD PLAT AS RECORDED AMONG THE MARYLAND LAND RECORDS IN PLAT BOOK 155 AS PLAT No. 17658 AND THAT THE TOTAL AREA ENCLOSED IN PHASE 4 OF THIS CONDOMINIUM IS 29,042 SQUARE FEET OR 0.67 OF AN ACRE OF LAND AND THAT THE LOCATIONS AND DIMENSIONS OF ALL EXISTING IMPROVEMENTS HAVE BEEN CAREFULLY ESTABLISHED BY A TRANCH-TAPE SURVEY (OR EQUIVALENT) AND THAT UNLESS SHOWN HEREON THERE ARE NO TRIBLE ENCROACHMENTS.


I FURTHER CERTIFY THAT IN ACCORDANCE WITH THE REQUIREMENTS OF THE REAL PROPERTY ARTICLE, TITLE 11, SECTION 11-102, of the ANNOTATED CODE OF MARYLAND (1988 REPL. VOL.) (THE MARYLAND CONDOMINIUM ACT) THIS PLAT TOGETHER WITH THE APPLICABLE PORTIONS OF THE DECLARATION IS A CORRECT REPRESENTATION OF THE CONDOMINIUM DESCRIBED AND THE IDENTIFICATION AND LOCATION OF EACH UNIT AND THE COMMON ELEMENTS, AS COMPUTED CAN BE DETERMINED FROM THESE.

DATE Nov. 7, 1992

Robert L. Cole
ROBERT L. COLE
PROPERTY LINE SURVEYOR
No. 05, 307

KEY WEST
CONDOMINIUM, INC.


DIAMONDBACK DRIVE
(SEE PLAN)

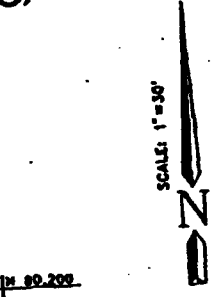

N 89.209
007'59" W

N 54.400
18 75.100

N 78.900
021'56" W

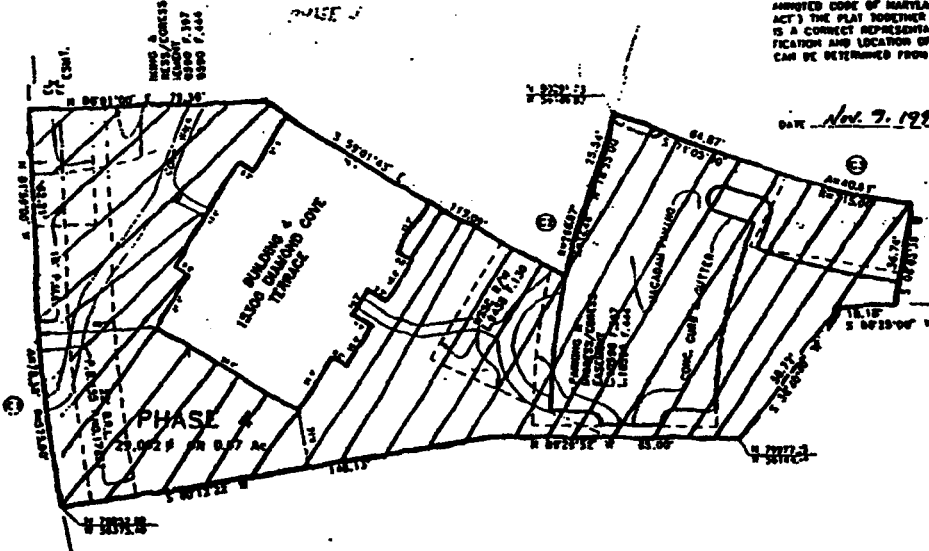

PARCEL A
DISCOVERY ADVENTURE
P.B. 155 P.NO. 17658

CONDOMINIUM PLAT
AS-BUILT PLAN
PHASE 4
DISCOVERY IV
CONDOMINIUM

GAITHERSBURG (19A) DISTRICT
MONTGOMERY COUNTY, MARYLAND
NOVEMBER, 1992 SCALE: 1"=30'

FILED
NOV 29 1992

CURVE NO.	BEARING	LENGTH	TANGENT	CHORD	MARKS & BEINGS
1	292.10°	20.11	18.97	15.10	17658
2	222.10°	18.11	17.07	14.10	17658
3	152.10°	16.11	15.17	12.10	17658
4	82.10°	14.11	13.27	10.10	17658
5	12.10°	12.11	11.37	8.10	17658

RECORDED _____
PLAT BOOK _____
PLAT NO. _____

Charles R. Adams & Associates, Inc.
SURVEYING AND ENGINEERING
1100 W. BROADWAY, SUITE 200
BETHESDA, MD 20814
(301) 462-1100



PLAT NO. 6504

F.F. & R.O. CROWN & A.
L. SA 75 F. 375

F.F. & R.O. CROWN & A.
L. SA 75 F. 375

OWNER'S DEDICATION

WE, POLK HOME CORPORATION, A MICHIGAN CORPORATION, OWNERS OF THE PROPERTY SHOWN HEREON AND DESCRIBED IN THE SURVEYOR'S CERTIFICATE, HEREBY ASSESS THESE PLATS AND PLANS OF CONDOMINIUM DEVELOPMENT, CONSISTING OF THREE SHEETS, PURSUANT TO THE PROVISIONS AND REQUIREMENTS OF THE REAL PROPERTY ARTICLE, TITLE 11, SECTION 11-101, of the ANNOTATED CODE OF MARYLAND (1988 REV. VOL.)

6/18/93
W. Owen Ford
OWNER

POLK HOME CORPORATION
BY: *Charles L. McCoskey*
CHARLES L. MCCOSKEY
PRESIDENT - FORMER OPERATIONS
ATTORNEY IN FACT

SURVEYOR'S CERTIFICATE

I HEREBY CERTIFY THAT THE INFORMATION SHOWN HEREON IS CORRECT, THAT IT IS PHASE 7 OF THE PROPERTY SHOWN AS DESCRIBED BY CONDOMINIUM, A CONDOMINIUM THAT IS PART OF THIS TRACT OF LAND DESCRIBED IN A CONVEYANCE BY DEY WEST LIMITED PARTNERSHIP, A MARYLAND LIMITED PARTNERSHIP TO POLK HOME CORPORATION, A MICHIGAN CORPORATION OF DEED DATED AUGUST 14, 1992, AND RECORDED AMONG THE LAST RECORDS OF MONTGOMERY COUNTY, MARYLAND IN LAND RECORD AS POLK 400. SAID PARCEL OF LAND ALSO BEING PART OF PARCEL B SHOWN A RESIDENTIAL DEVELOPMENT AS DESCRIBED BY A SUBSEQUENT RECORDS PLAN AS REFERRED TO AS PARCEL B (LAND BEING IN PLAT 1800 III AS PLAT NO. 17700 AND THAT THE TOTAL AREA DESCRIBED IN PHASE 7 OF THIS CONVEYANCE IS 172,190 SQUARE FEET OR 3.98 ACRES OF LAND AND THAT THE LOCATIONS AND DIMENSIONS OF ALL EXISTING IMPROVEMENTS HAVE BEEN CAREFULLY ESTABLISHED BY A TRANSIT-TYPE SURVEY (SEE CONVEYANCE) AND THAT UNLESS SHOWN OTHERWISE THERE ARE NO WHEEL ENCROACHMENTS.

I FURTHER CERTIFY THAT IN ACCORDANCE WITH THE REQUIREMENTS OF THE REAL PROPERTY ARTICLE, TITLE 11, SECTION 11-102, of the ANNOTATED CODE OF MARYLAND (1988 REV. VOL.) (THE MARYLAND CONDOMINIUM ACT) THE PLAN HENCEON WITH THE APPLICABLE PORTION OF THE DECLARATION IS A CORRECT REPRESENTATION OF THE CONDOMINIUM DESCRIBED AND THE IDENTIFICATION AND LOCATION OF EACH UNIT AND THE COMMON ELEMENTS, AS CONSTRUCTED, CAN BE DETERMINED FROM THEM.

DATE: *5/28/93*


R. L. Collier
RONALD L. COLLIER
PROPERTY LINE SURVEYOR
NO. 10, 307

CURVE TABLE					
Angle (Degrees)	Area (Sq. Ft.)	Chord (Feet)	Radius (Feet)	Center (Feet)	Offset (Feet)
1	11.33	18.33	12.33	1.33	1.33

PARCEL B
DISCOVERLY-ADVENTURE
P.B. 155 P.N.O. 17858


FILED
JUN 04 1993

CONDOMINIUM PLAT
AS-BUILT PLAN
PHASE 7
DISCOVERLY IV
CONDOMINIUM
GAITHERSBURG (9th) DISTRICT
MONTGOMERY COUNTY, MARYLAND
MAY, 1993 SCALE: 1"=50'

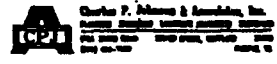

SEE P. 10
RECORD

ASA 334 1264-65-2

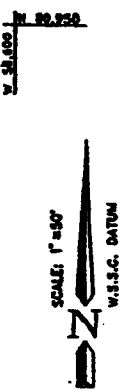

RECORDED: _____
PLAT BOOK: _____
PLAT NO.: _____

Maryland State Archives

PLAT NO. 6548

OWNER'S DEDICATION

WE, PULKE HOME CORPORATION, A MICHIGAN CORPORATION, OWNERS OF THE PROPERTY SHOWN HEREON AND RECORDER IN THE SURVEYOR'S CERTIFICATE, HEREBY ADAPT THESE PLATS AND PLANS OF CONDOMINIUM SUBDIVISION, CONSISTING OF THREE SHEETS, PURSUANT TO THE PROVISIONS AND REQUIREMENTS OF THE REAL PROPERTY ARTICLE, TITLE 11, SECTION 11-102, et seq., OF THE ANNOTATED CODE OF MARYLAND (1988 REPL. VOL.)

7/2/93
July 2, 1993

PULKE HOME CORPORATION
[Signature]
ATTORNEY IN FACT


SURVEYOR'S CERTIFICATE

I HEREBY CERTIFY THAT THE INFORMATION SHOWN HEREON IS CORRECT, THAT IT IS PART OF THE PROPERTY SHOWN AS DESCRIBED IN CONDOMINIUM, A CONDOMINIUM, THAT IS PART OF THE TRACT OF LAND SHOWN IN A CONVEYANCE BY KEY WEST LIMITED PARTNERSHIP, A MARYLAND LIMITED PARTNERSHIP TO PULKE HOME CORPORATION, A MICHIGAN CORPORATION BY DEED DATED FEBRUARY 1 AND RECORDED AMONG THE LAND RECORDS OF MONTGOMERY COUNTY, MARYLAND AS LAND SYSTEM AS PLAT NO. 17858 AND PART OF LAND IN AN ORDER PLAT BY DEWEY B. BROWN & COMPANY, P.L.L.C. AND PART OF LAND IN A CONVEYANCE BY DEED PLAT AS DESCRIBED AMONG THE RECORDS OF MONTGOMERY COUNTY, MARYLAND AS PLAT NO. 17788 AND THAT THE TOTAL AREA DESCRIBED IN PHASE 8 OF THIS CONDOMINIUM IS 38,049 SQUARE FEET OR 1.28 ACRES OF LAND AND THAT THE LOCATIONS AND DIMENSIONS OF ALL EXISTING IMPROVEMENTS HAVE BEEN CAREFULLY ESTABLISHED BY A TRAVEL-TAPE SURVEY (SEE SUPPLEMENT) AND THAT COLLISION SHOWN HEREON THERE ARE NO VISIBLE ENCROACHMENTS.

I FURTHER CERTIFY THAT IN ACCORDANCE WITH THE REQUIREMENTS OF THE REAL PROPERTY ARTICLE, TITLE 11, SECTION 11-102, et seq., OF THE ANNOTATED CODE OF MARYLAND (1988 REPL. VOL.) (THE MARYLAND CONDOMINIUM ACT) THE PLAT TOGETHER WITH THE APPLICABLE PORTIONS OF THE DECLARATION IS A CORRECT REPRESENTATION OF THE CONDOMINIUM DESCRIBED AND THE IDENTIFICATION AND LOCATION OF EACH UNIT AND THE COMMON ELEMENTS, AS CONSTRUCTED AND AS DETERMINED FROM THEM.

DATE: 6-18-93

[Signature]
RONALD L. COLLIER
PROPERTY LINE SURVEYOR
NO. 10, 387

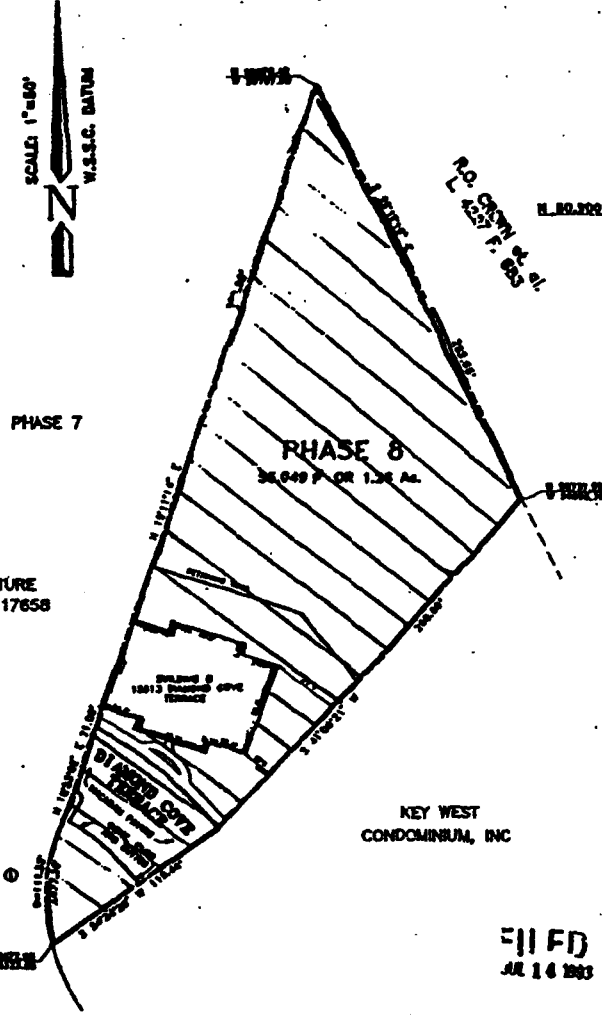

N 89,100
W 34,450

SCALE: 1"=50'
N
U.S.S.C. DATUM

PHASE 7

PARCEL B
DISCOVERLY ADVENTURE
P.B. 155 P.NO. 17858

KEY WEST
CONDOMINIUM, INC

FILED
JUL 16 1993

CONDOMINIUM PLAT
AS-BUILT PLAN
PHASE 8
DISCOVERLY IV
CONDOMINIUM
GATHERSBURG (9th) DISTRICT
MONTGOMERY COUNTY, MARYLAND
JUNE, 1993 SCALE: 1"=50'

STATION	CHORD BEARING	CHORD DISTANCE	ARC DISTANCE	ANGLE
1+00.00	S 89° 15' 00" W	100.00	100.00	90.00
1+10.00	S 89° 15' 00" W	100.00	100.00	90.00
1+20.00	S 89° 15' 00" W	100.00	100.00	90.00
1+30.00	S 89° 15' 00" W	100.00	100.00	90.00
1+40.00	S 89° 15' 00" W	100.00	100.00	90.00
1+50.00	S 89° 15' 00" W	100.00	100.00	90.00
1+60.00	S 89° 15' 00" W	100.00	100.00	90.00
1+70.00	S 89° 15' 00" W	100.00	100.00	90.00
1+80.00	S 89° 15' 00" W	100.00	100.00	90.00
1+90.00	S 89° 15' 00" W	100.00	100.00	90.00
2+00.00	S 89° 15' 00" W	100.00	100.00	90.00

RECORDED: _____
PLAT BOOK: _____
PLAT NO.: _____

CA Charles F. Johnson & Associates, Inc.
PLANNING ENGINEERING SURVEYING
2000 W. BROAD ST. SUITE 2000, WASHINGTON, DC 20004
(202) 638-1200 FAX: (202) 638-1201

USA 5241264-73-2

18469 120

State of Maryland Land Instrument Intake Sheet

Baltimore City County: MONTGOMERY

Information provided is for the use of the Clerk's Office, State Department of Assessments and Taxation, and County Finance Office only.

(Type or Print in Black Ink Only — All Copies Must Be Legible)

Space Reserved for Circuit Court Clerk Recording Validity

1	Type(s) of Instruments	<input type="checkbox"/> Check Box if Addendum Intake Form is Attached.)						
	<input type="checkbox"/> Deed	<input type="checkbox"/> Mortgage	<input checked="" type="checkbox"/> Other <u>ADDENDUM</u>	<input type="checkbox"/> Other TO:				
	<input type="checkbox"/> Deed of Trust	<input type="checkbox"/> Lease	<input type="checkbox"/> <u>10540/425</u>					
2	Conveyance Type Check Box	<input type="checkbox"/> Improved Sale Arms-Length [1]	<input type="checkbox"/> Unimproved Sale Arms-Length [2]	<input type="checkbox"/> Multiple Accounts Arms-Length [3]	<input type="checkbox"/> Not an Arms-Length Sale [9]			
3	Tax Exemptions (if Applicable) Site or Explain Authority	<input type="checkbox"/> Recordation						
		<input type="checkbox"/> State Transfer						
		<input type="checkbox"/> County Transfer						
4	Consideration and Tax Calculations	Consideration Amount		Finance Office Use Only				
		Purchase Price/Consideration	\$	Transfer and Recordation Tax Consideration				
		Any New Mortgage	\$	Transfer Tax Consideration	\$			
		Balance of Existing Mortgage	\$	X () % =	\$			
		Other:	\$	Less Exemption Amount	\$			
				Total Transfer Tax	\$			
		Other:	\$	Recordation Tax Consideration	\$			
				X () per \$500 =	\$			
		Full Cash Value	\$	TOTAL DUE	\$			
5	Fees	Amount of Fees	Doc. 1	Doc. 2	Agent:			
		Recording Charge	\$	\$				
		Surcharge	\$	\$	Tax Bill:			
		State Recordation Tax	\$	\$				
		State Transfer Tax	\$	\$	C.B. Credit:			
		County Transfer Tax	\$	\$				
		Other	\$	\$	Ag. Tax/Other:			
		Other	\$	\$				
3	Description of Property	District	Property Tax ID No. (1)	Grantor Liber/Folio	Map	Parcel No.	Var. LOG	
			<u>9-72-285959B</u>				<input type="checkbox"/> (5)	
		Subdivision Name		Lot (3a)	Block (3b)	Sect/AR(3c)	Plat Ref.	SqFt/Acreage (4)
		<u>KEY WEST CONDOMINIUM, INC.</u>						
		Location / Address of Property Being Conveyed (2)						
		Other Property Identifiers (if applicable)					Water Meter Account No.	

Description of Property SDAT requires submission of all applicable information. A maximum of 40 characters will be entered in accordance